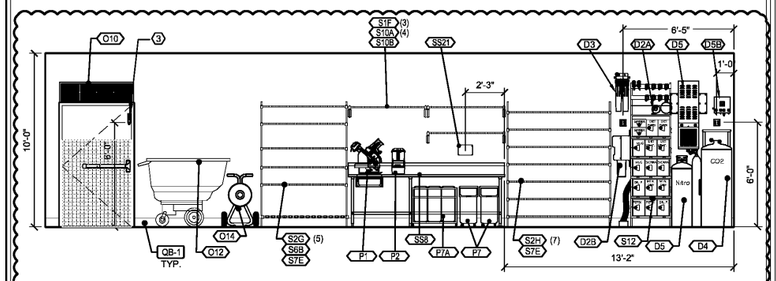

1 ELEVATION : BACKROOM

1/4" = 1'-0" NOTE:

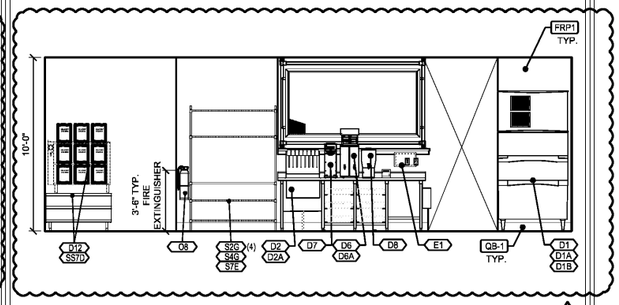

2 ELEVATION : SERVER

1/4" = 1'-0" NOTE:

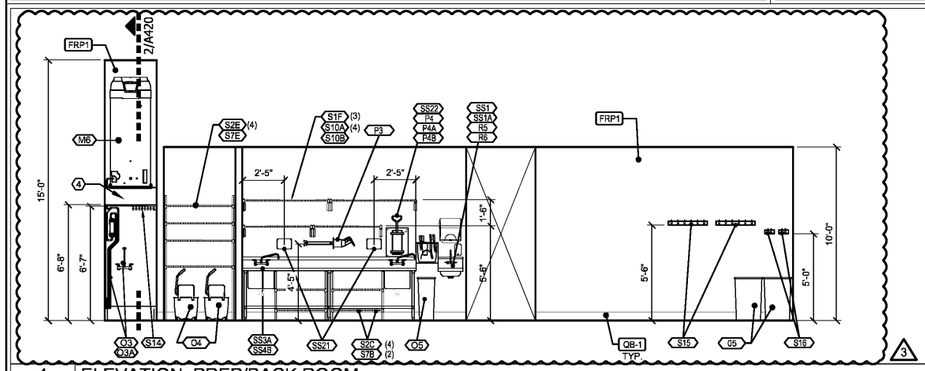

4 ELEVATION: PREP/BACK ROOM

1/4" = 1'-0" NOTE:

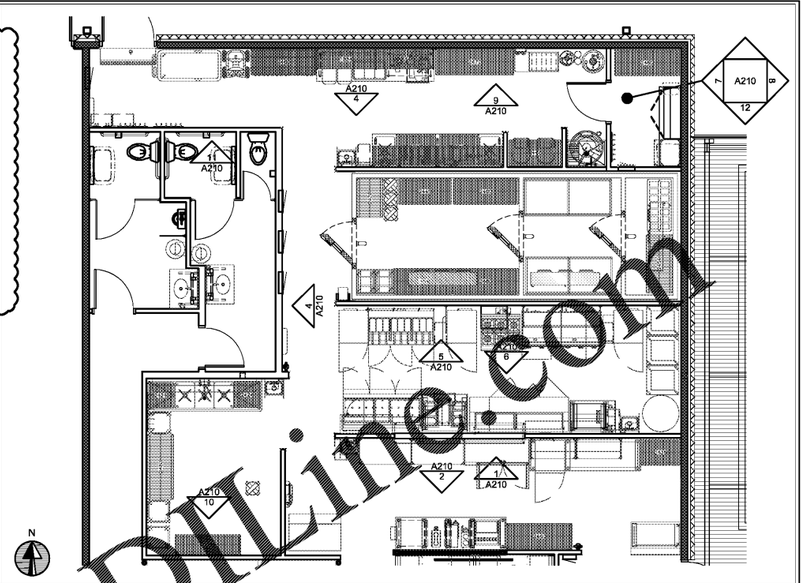

3 KEY PLAN: KITCHEN

1/8" = 1'-0" NOTE:

KEY NOTES:

1. HOOD, SEE MECHANICAL.
2. METAL SCREEN, SEE DETAIL 4/A430.
3. DETEX EAX-510
4. WATER HEATER PLATFORM.

GENERAL NOTES:

1. SEE SHEETS K3, K4, & K5 FOR EQUIPMENT SCHEDULE.
2. SEE SHEET A127 FOR WALL FINISH PLAN.

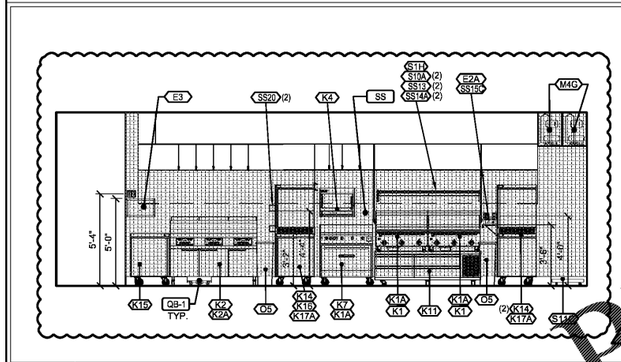

5 ELEVATION: BACK ROOM/ COOK LINE

1/4" = 1'-0" NOTE:

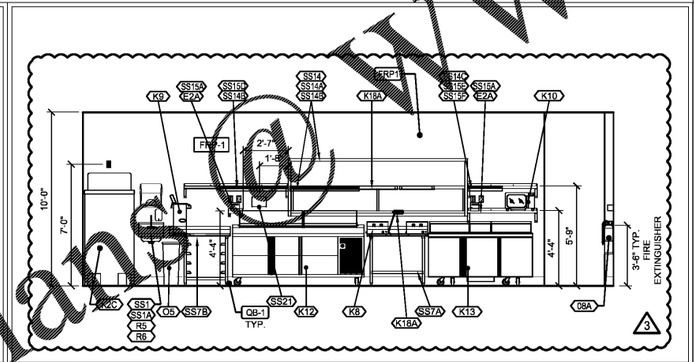

6 ELEVATION: INSIDE EXPO

1/4" = 1'-0" NOTE:

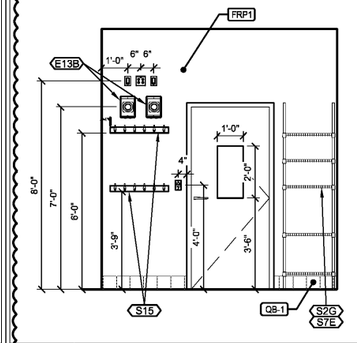

7 ELEVATION: OFFICE

3/8" = 1'-0" NOTE:

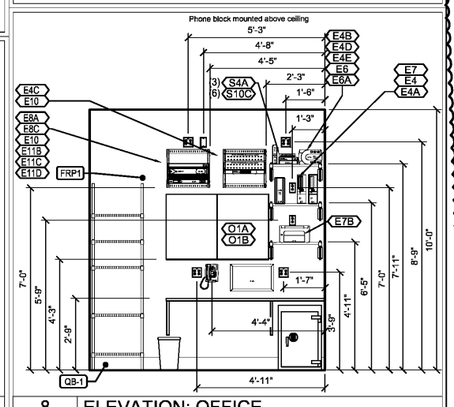

8 ELEVATION: OFFICE

3/8" = 1'-0" NOTE:

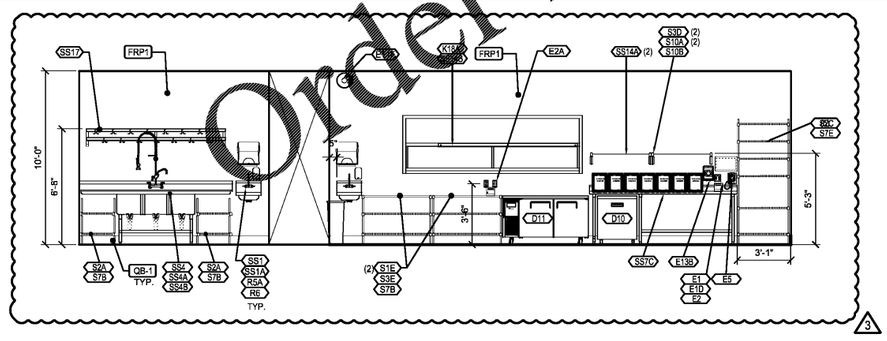

9 ELEVATION: DISH/ OUTSIDE EXPO

1/4" = 1'-0" NOTE:

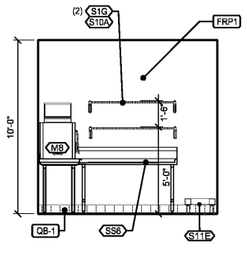

10 ELEVATION: DISH

1/4" = 1'-0" NOTE:

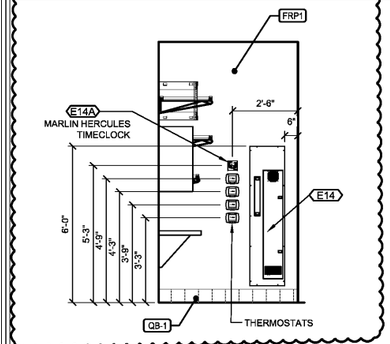

12 ELEVATION: OFFICE

3/8" = 1'-0" NOTE:

13 NOT USED

3/8" = 1'-0" NOTE:

Order Plans @ WWW.BLine.com

CONSULTANT:

JOHN SPONSELLER, ARCHITECT

8025 W. 25TH PL
LAKEWOOD, CO 80214
TEL: (303) 815-0161

STATE OF ALABAMA
JOHN C. SPONSELLER
REGISTERED ARCHITECT
8242

Bad Daddy's BURGER BAR

GOOD TIMES RESTAURANTS, INC.
141 Union Blvd, Suite 400
Lakewood, CO 80228
303-384-1430

BAD DADDY'S BURGER BAR
"EASTCHASE"
THE VENUE EASTCHASE
NWC EASTCHASE PKWY &
EASTCHASE LN.
MONTGOMERY, AL 36117

Issue Record:

4.23.2019	FOR PLAN REVIEW

Revisions:

1 5.6.2019	WALKIN BOX
2 7.1.2019	CANOPY REVS
3 2.10.2021	TO GO REVS

Drawn: DRAWN BY: JS, KC

Checked: CHECKED BY: JS

Project No. PROJECT#: 19-207

Contents: INTERIOR ELEVATIONS

3
A210

Date of Last Print: 2.10.2021